


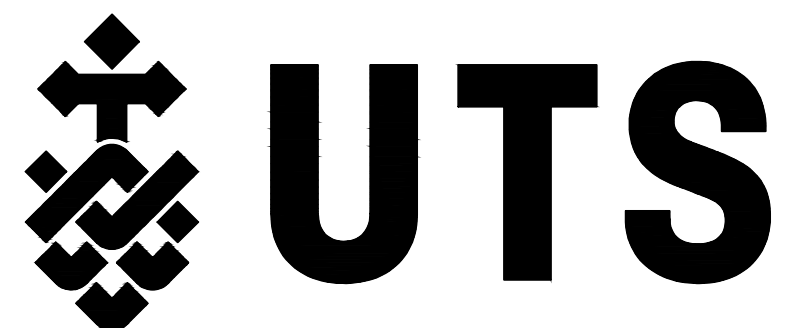
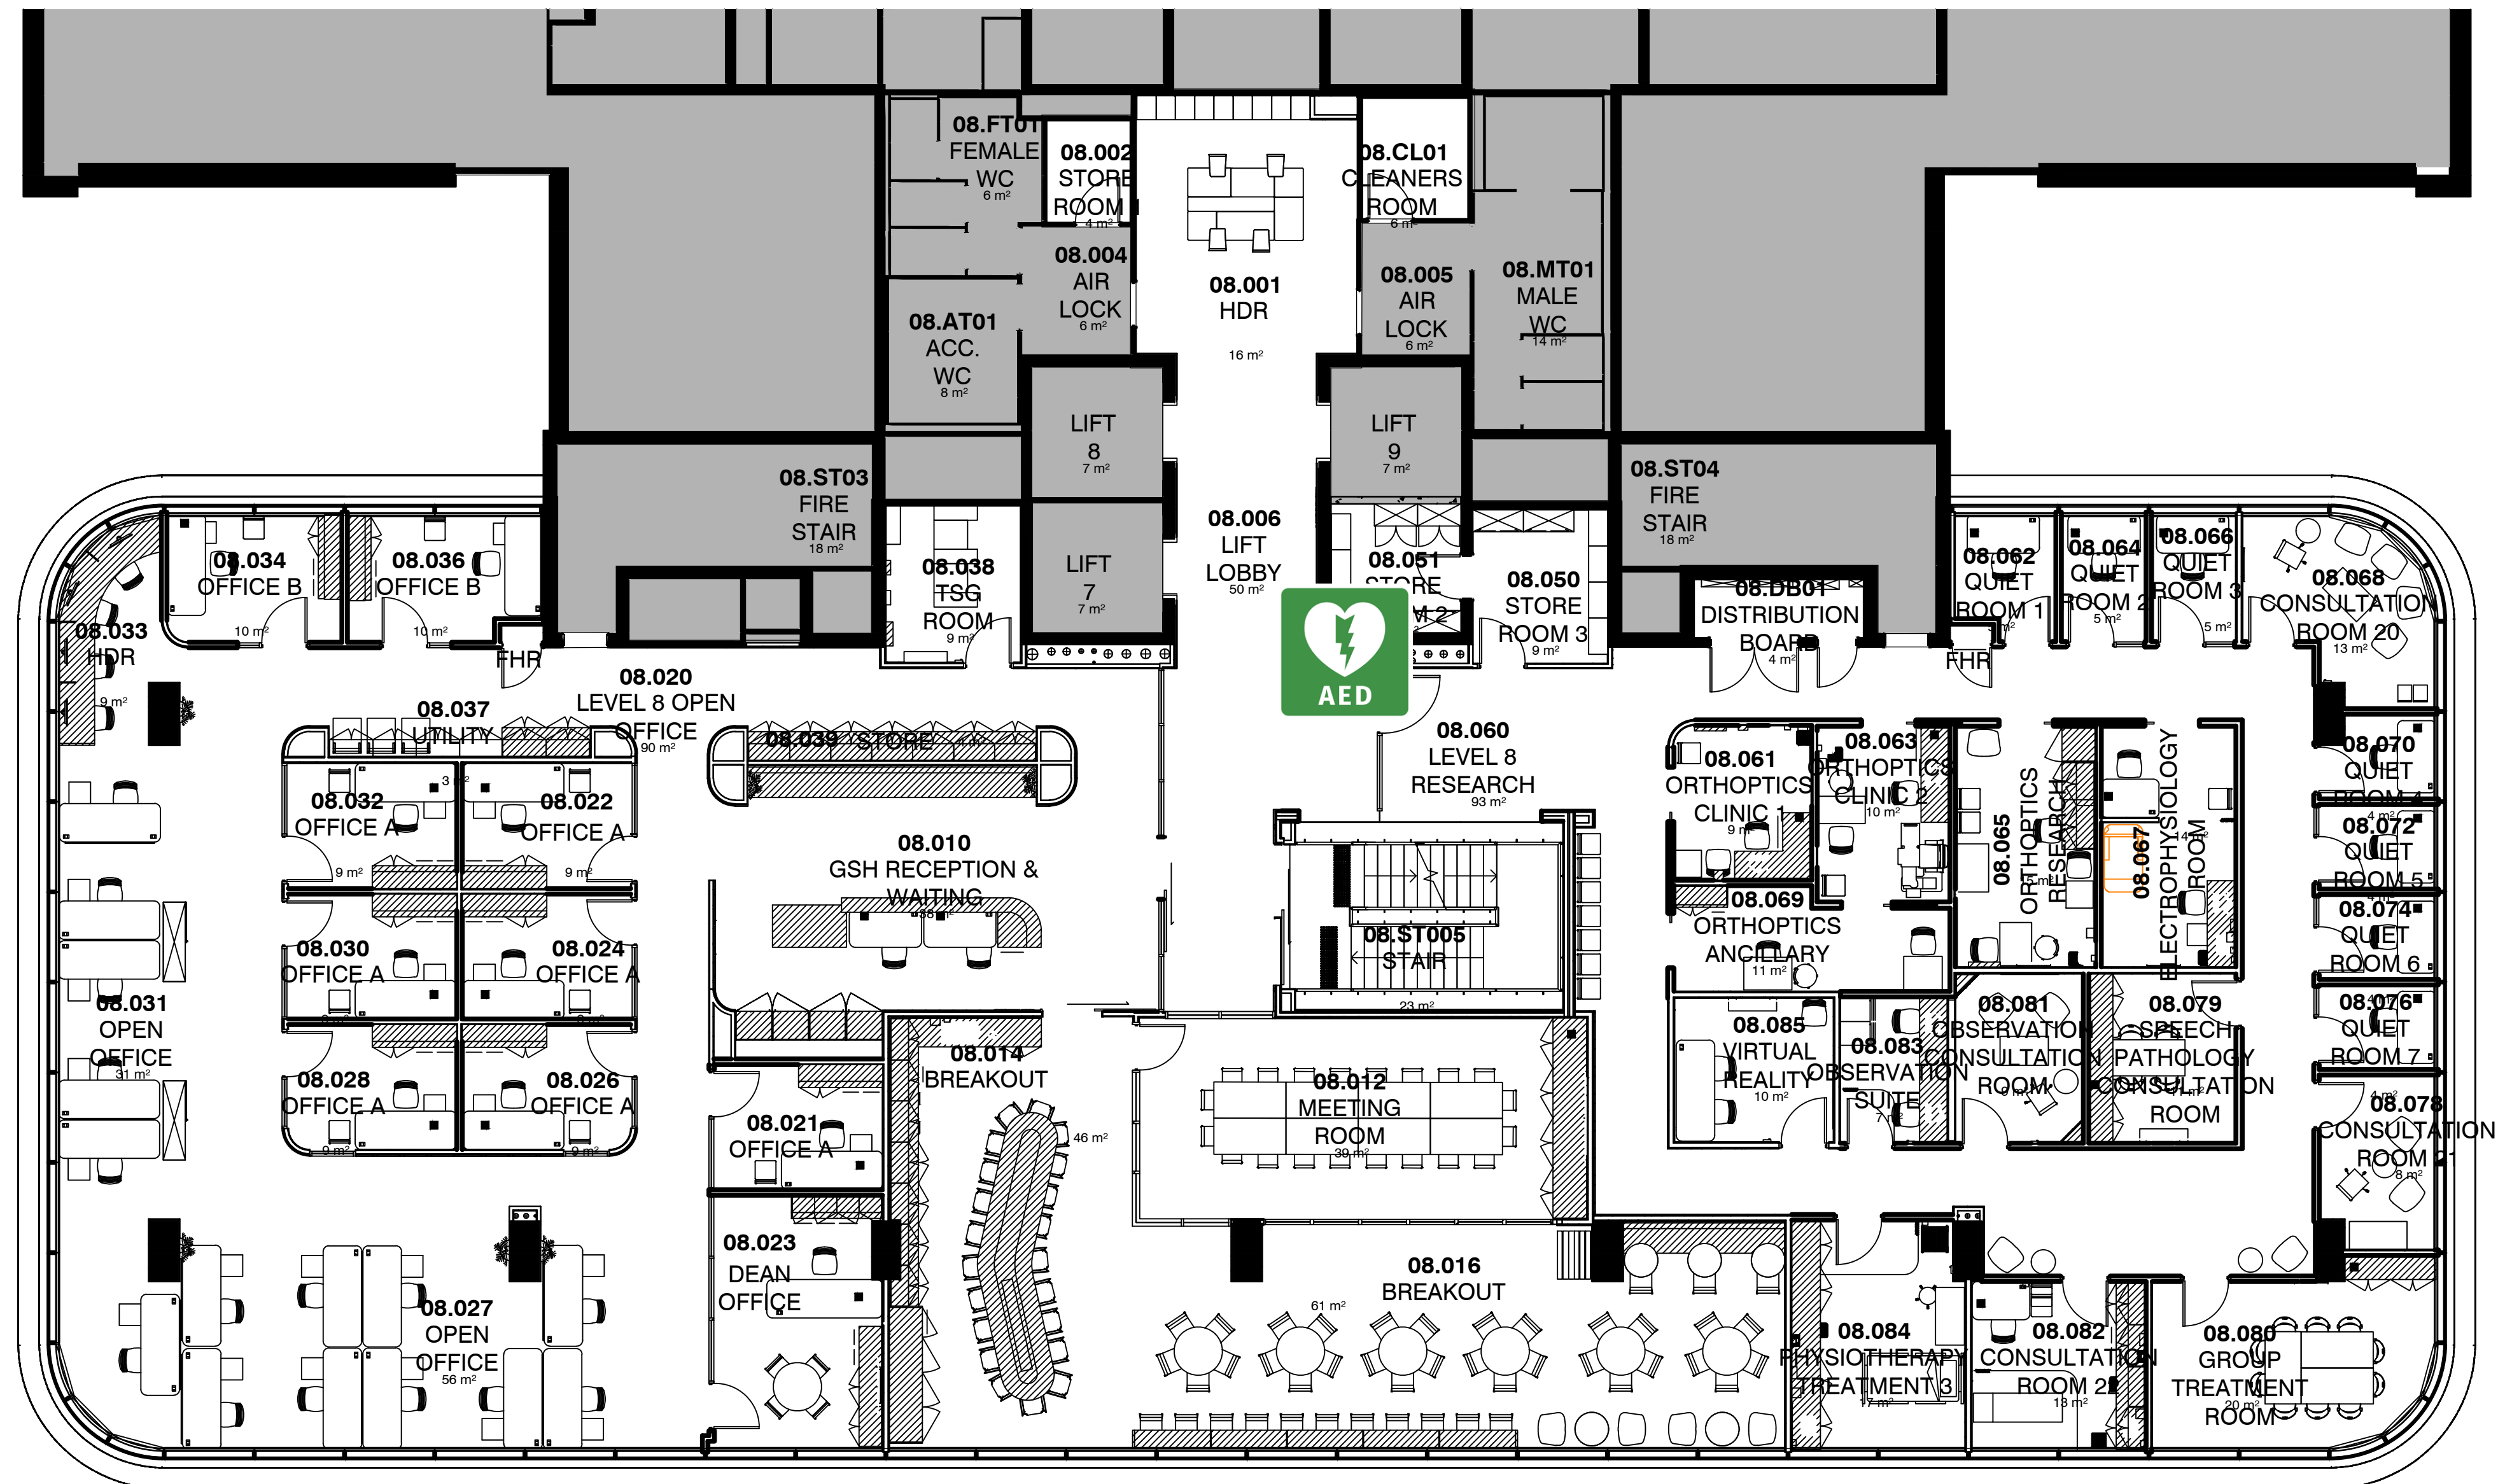


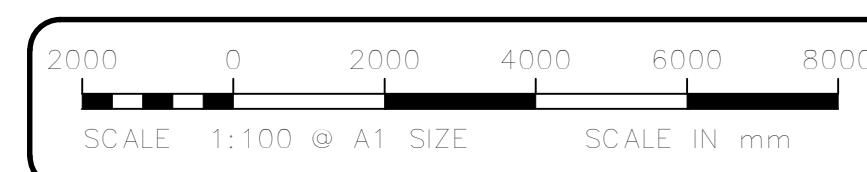

**CITY
BUILDING 20
LEVEL 08**

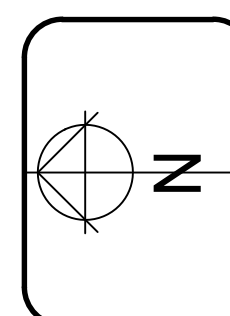

Rev 1 08.023 DEANS OFFICE UPDATE, NOVEMBER 2019

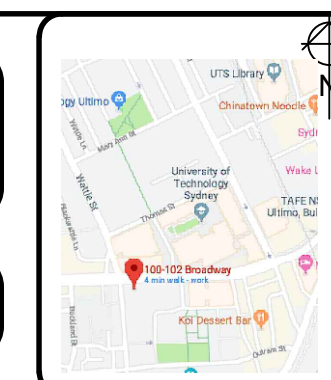

Facilities Management Operations

AS BUILT

AUGUST 2019

CB2008AP-74515_00